



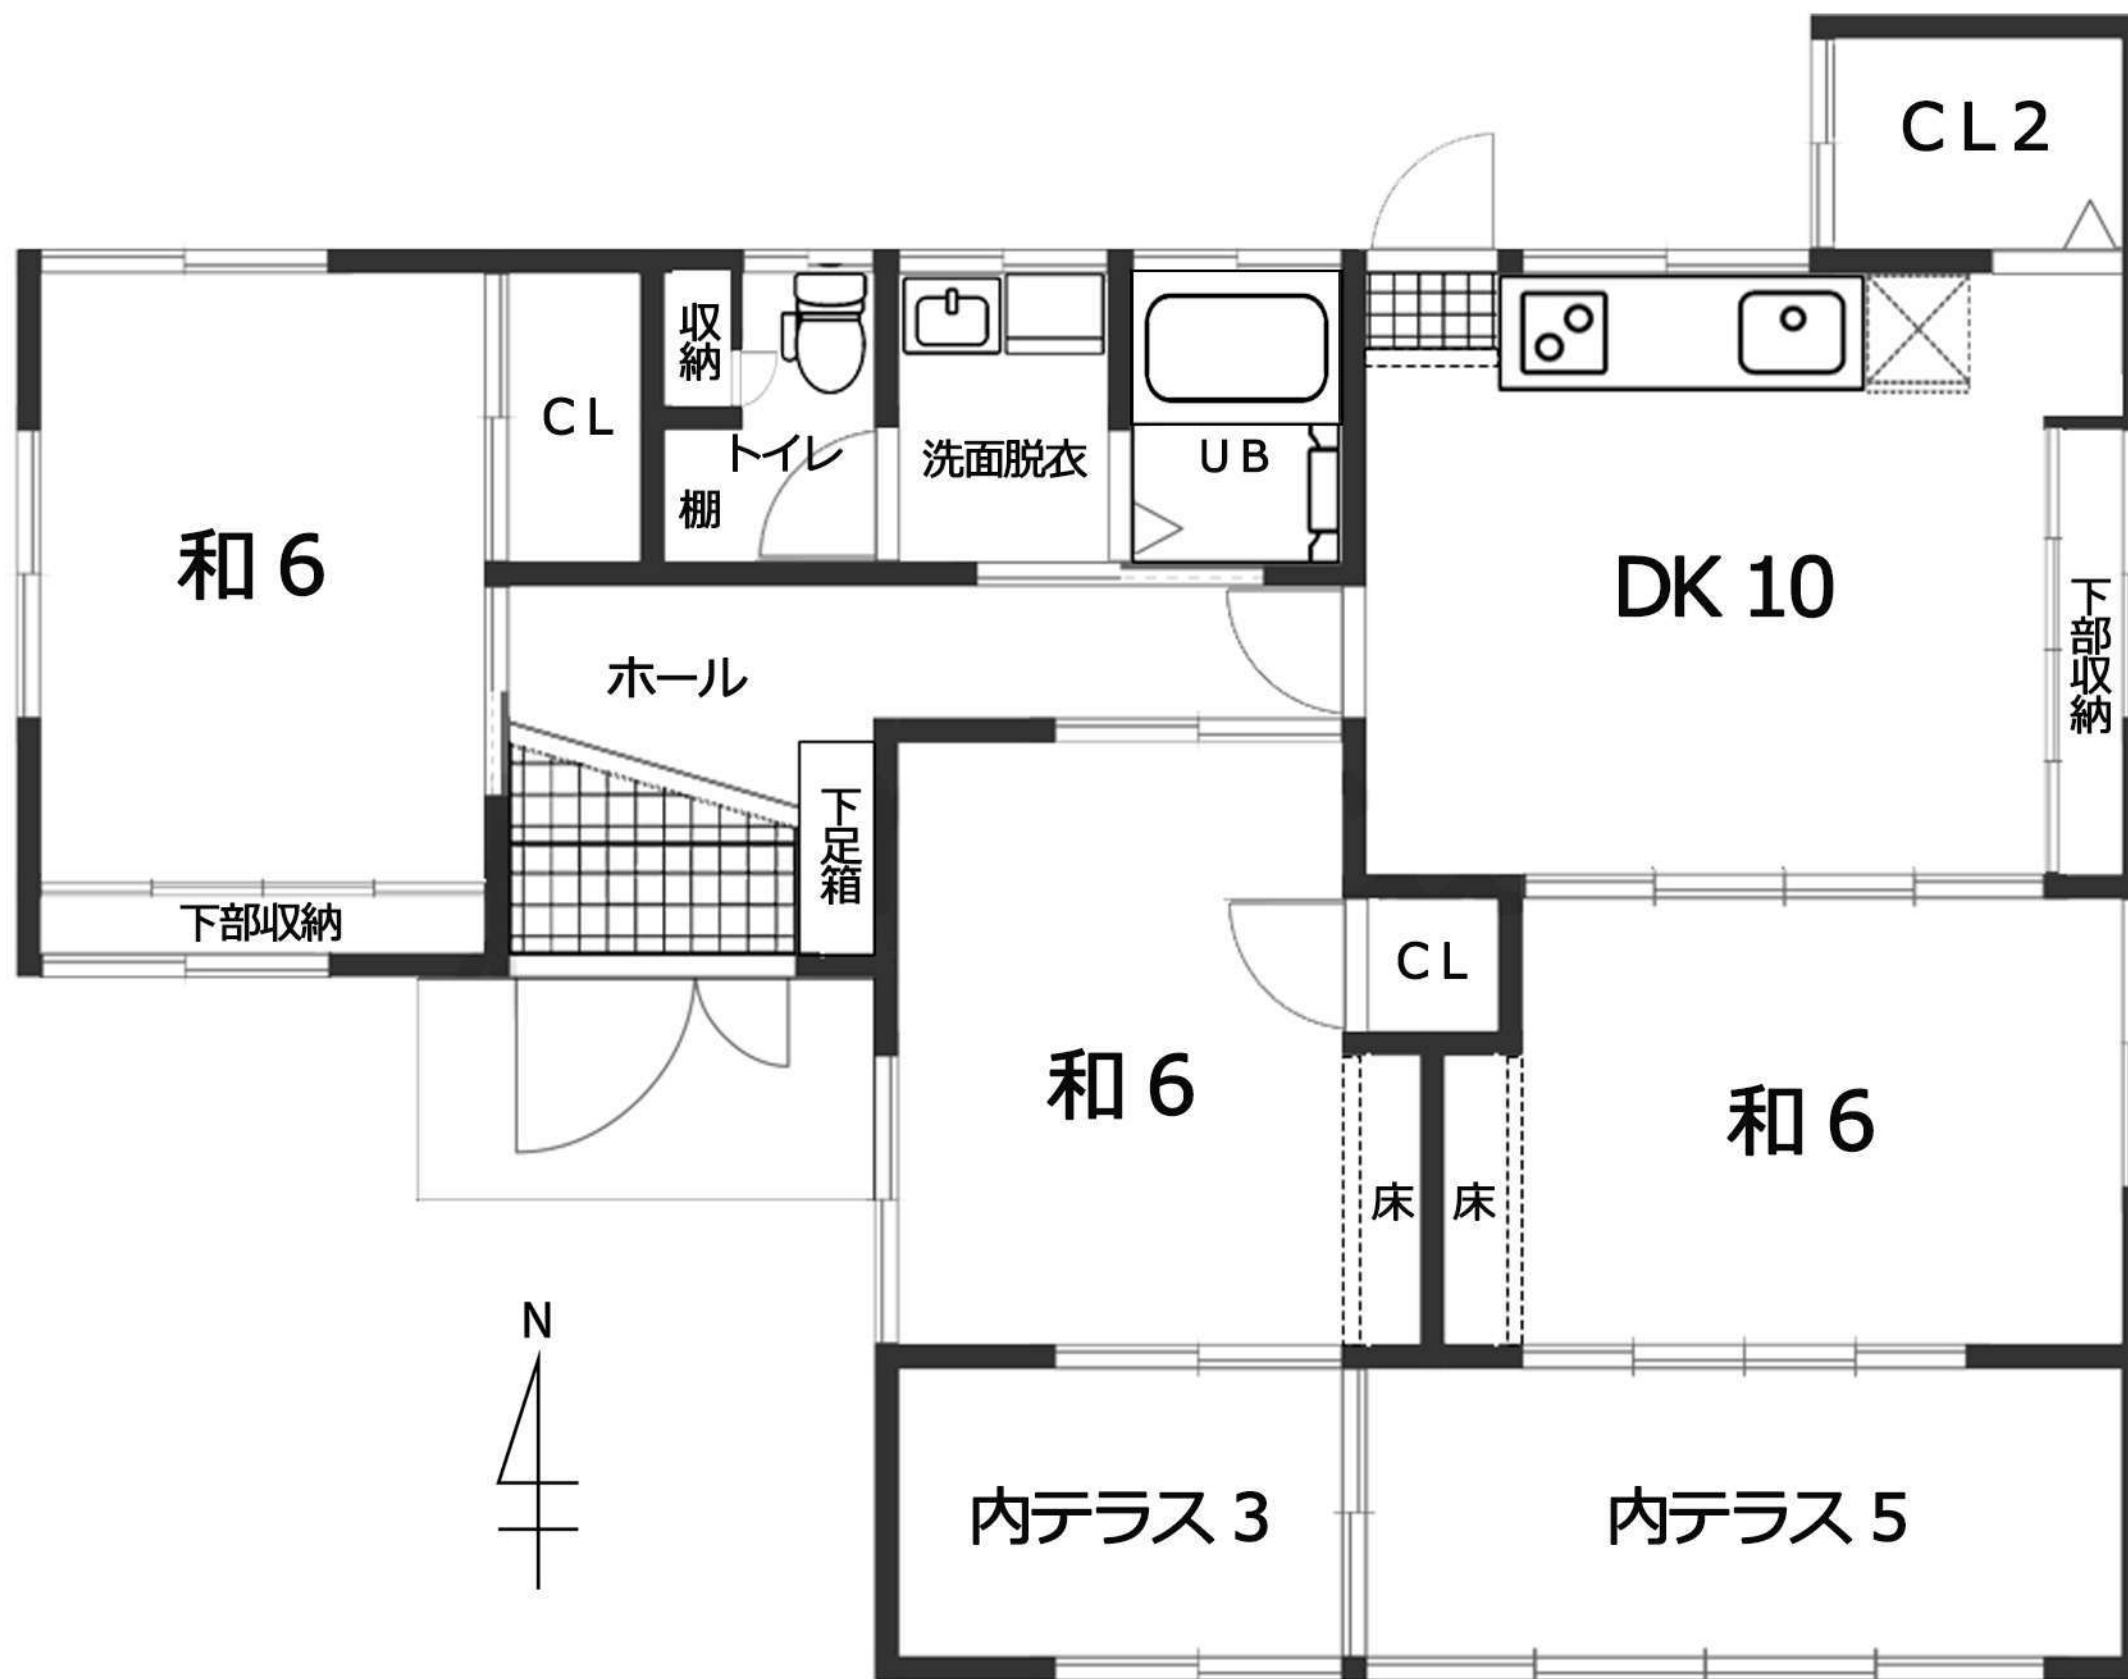

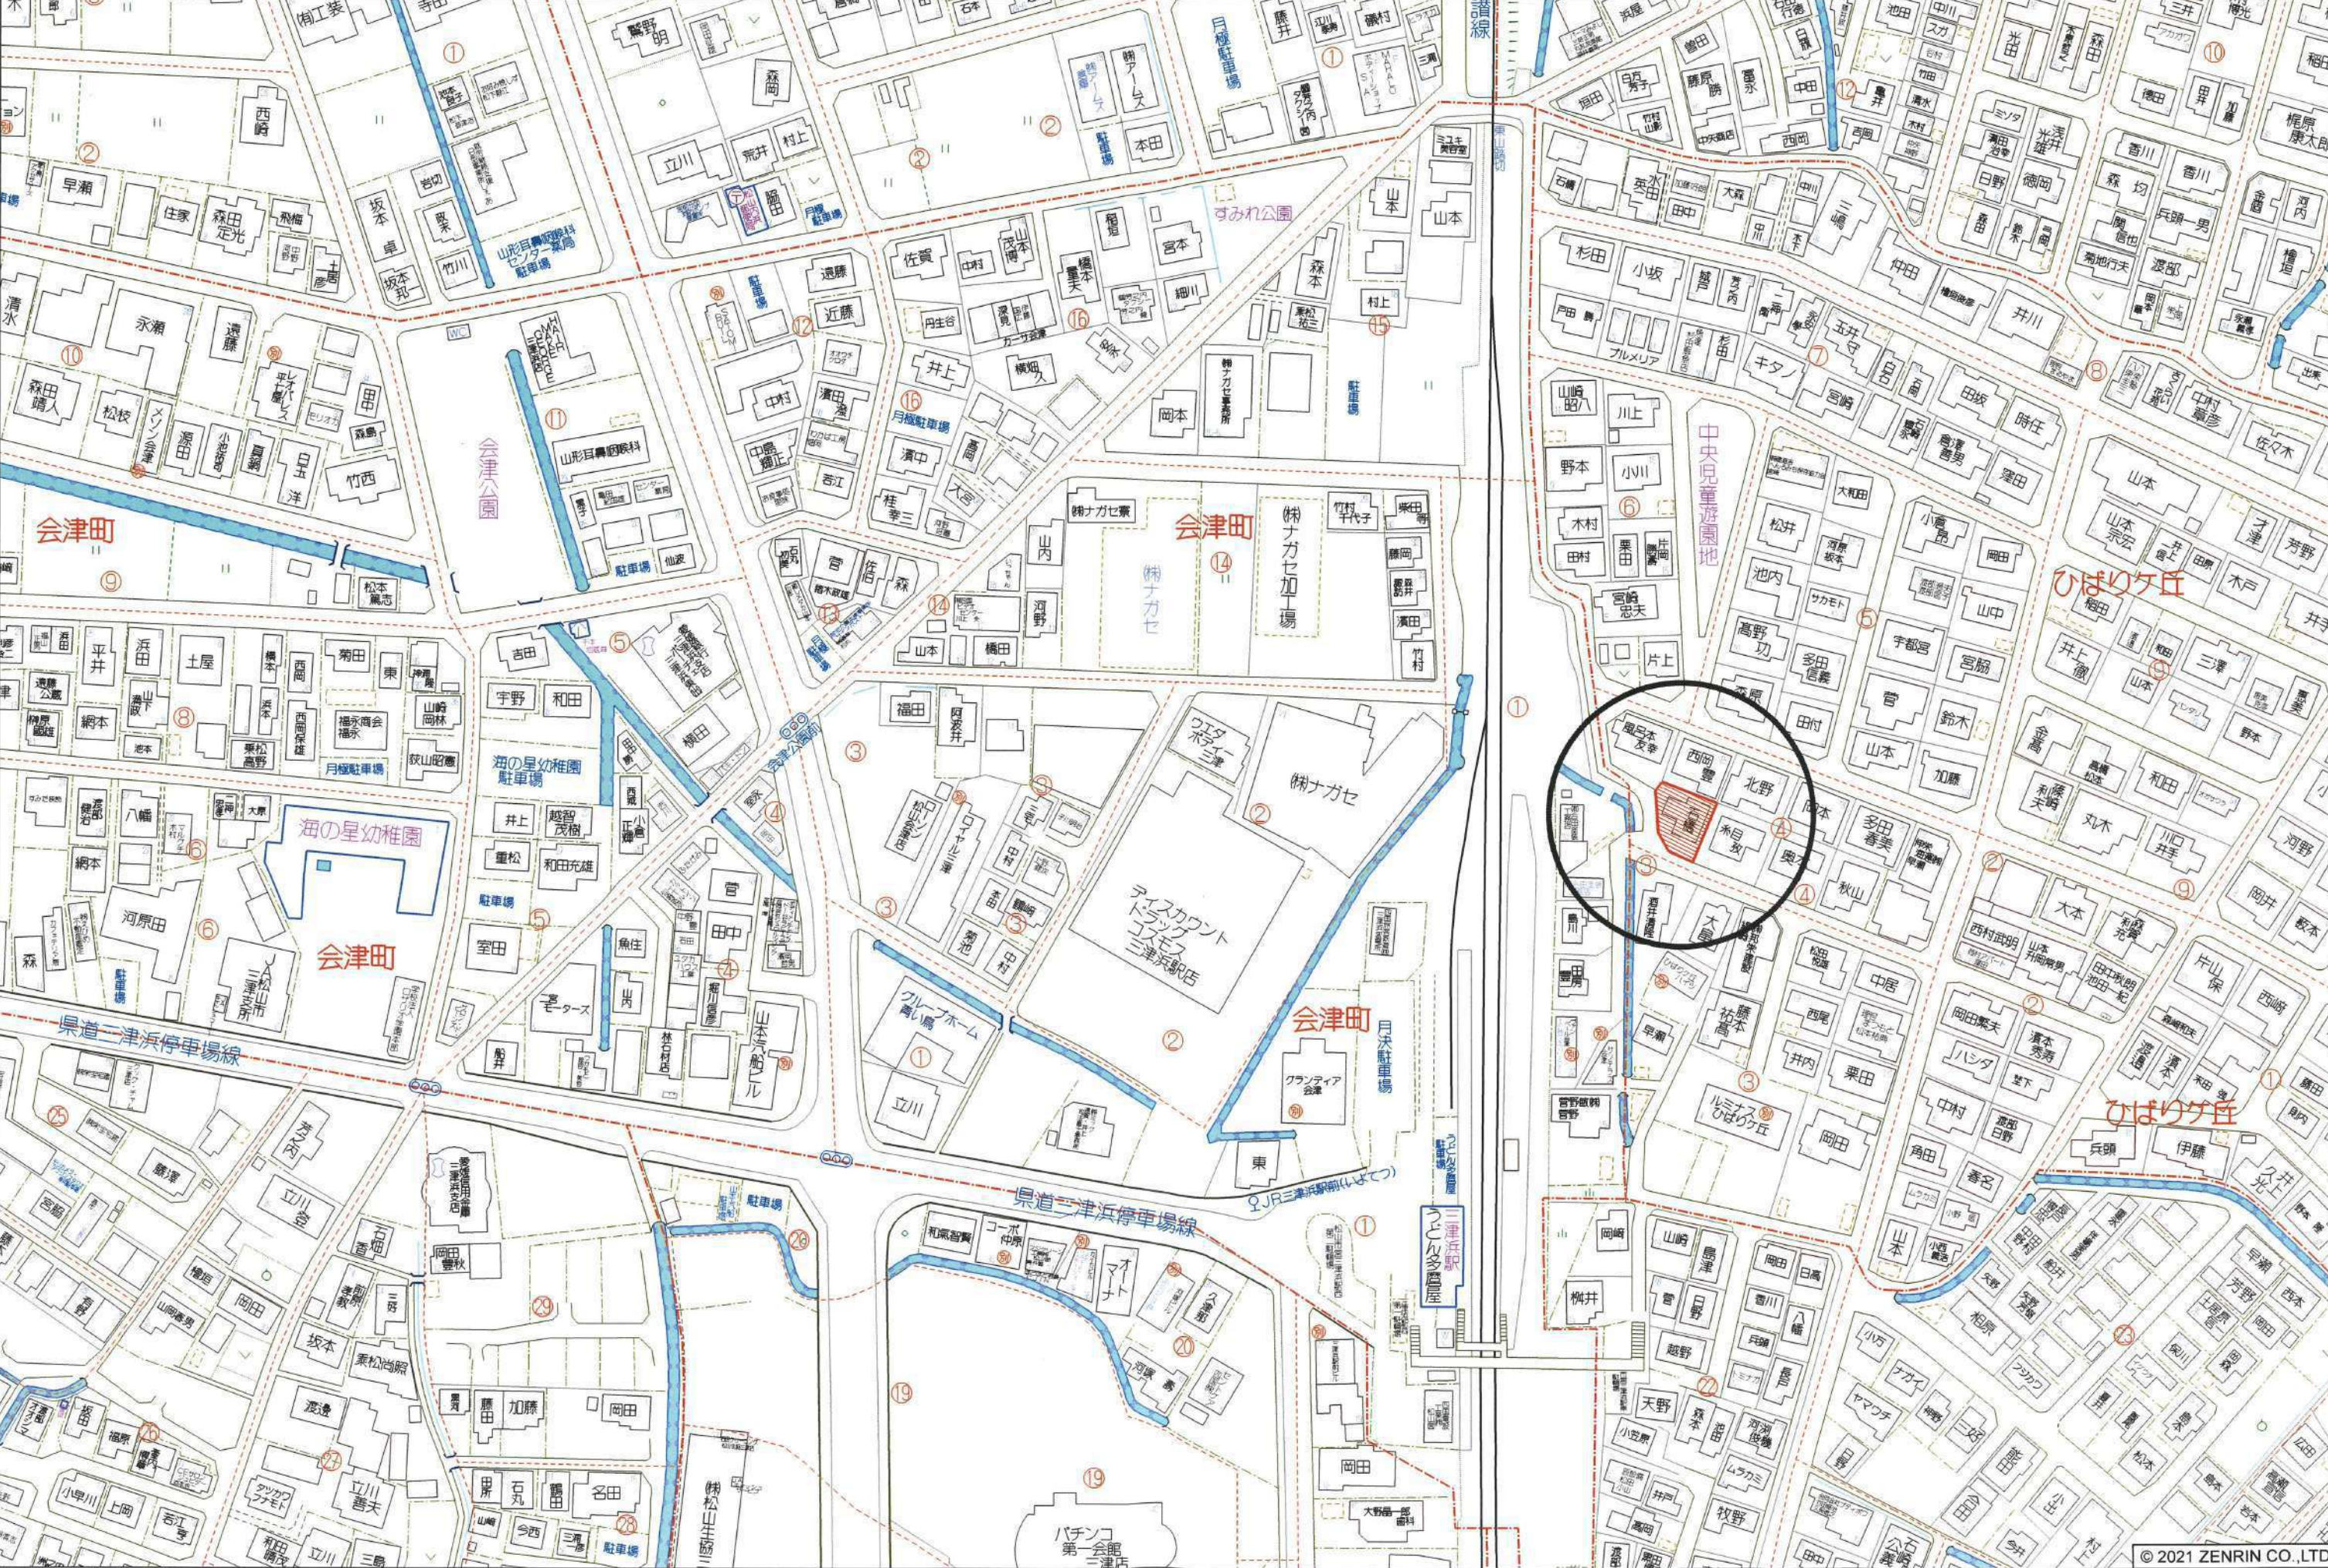

112438

前 3757 後新 3757-1~55.

地 積 測 量 図

7/49

地 番 3757-2 43~49 -1


土地の所在：松山市 ~~中道町~~ ~~中道町~~

ひばりヶ丘

~45
 $21.50 \times (10.70 + 10.60) = 457.95$
 = 除 228.975
 $0.3025 \times 228.975 = 69.264$ 坪

~44
 $21.50 \times (10.80 + 10.70) = 462.25$
 = 除 231.125
 $0.3025 \times 231.125 = 69.915$ 坪

~43
 $21.40 \times (10.70 + 10.70) = 457.96$
 = 除 228.98
 $0.3025 \times 228.98 = 69.266$ 坪

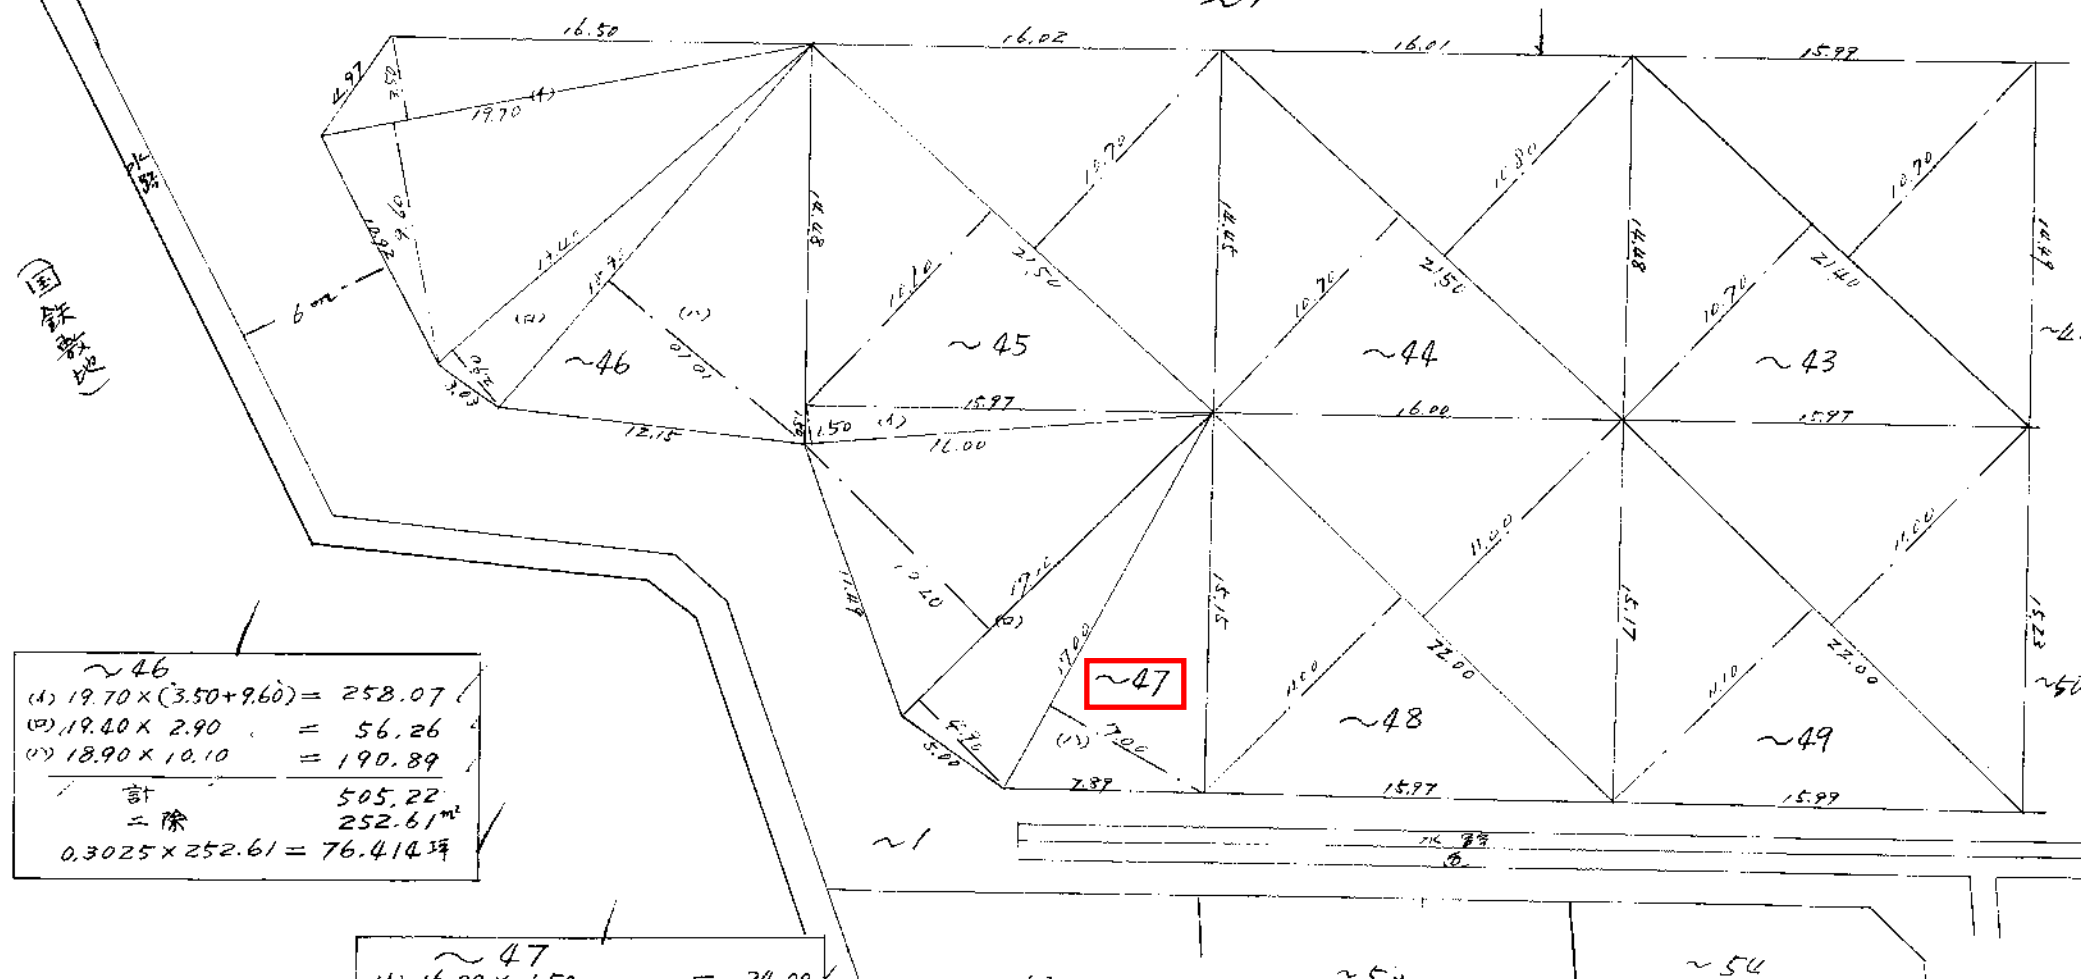

~46
 (A) $19.70 \times (3.50 + 9.60) = 258.07$
 (B) $19.40 \times 2.90 = 56.26$
 (C) $18.90 \times 10.10 = 190.89$
 計 505.22
 = 除 252.61
 $0.3025 \times 252.61 = 76.414$ 坪

~47
 (A) $16.00 \times 1.50 = 24.00$
 (B) $17.10 \times (10.20 + 4.90) = 258.21$
 (C) $17.00 \times 7.00 = 119.00$
 計 401.21
 = 除 200.605
 $0.3025 \times 200.605 = 60.683$ 坪

~48
 $22.00 \times (11.00 + 11.00) = 484.00$
 = 除 242.00
 $0.3025 \times 242.00 = 73.205$ 坪

~49
 $22.00 \times (11.10 + 11.00) = 486.20$
 = 除 243.10
 $0.3025 \times 243.10 = 73.537$ 坪

昭和40年9月26日


作成者

松山市役所建築課
 技師 矢野昌平



申請人

宇都宮孝

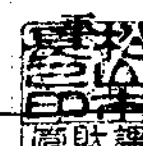

縮 尺 1/300

特選033 40.5 2.000 B4


S.40.9.7.

112440 前 3757 後新 3757-1~55

土地の所在図 9/9
地積測量図

地番 ~1 3757 ~ 3757-55
土地の所在 松山市 中須賀町三十九

ひばりヶ丘

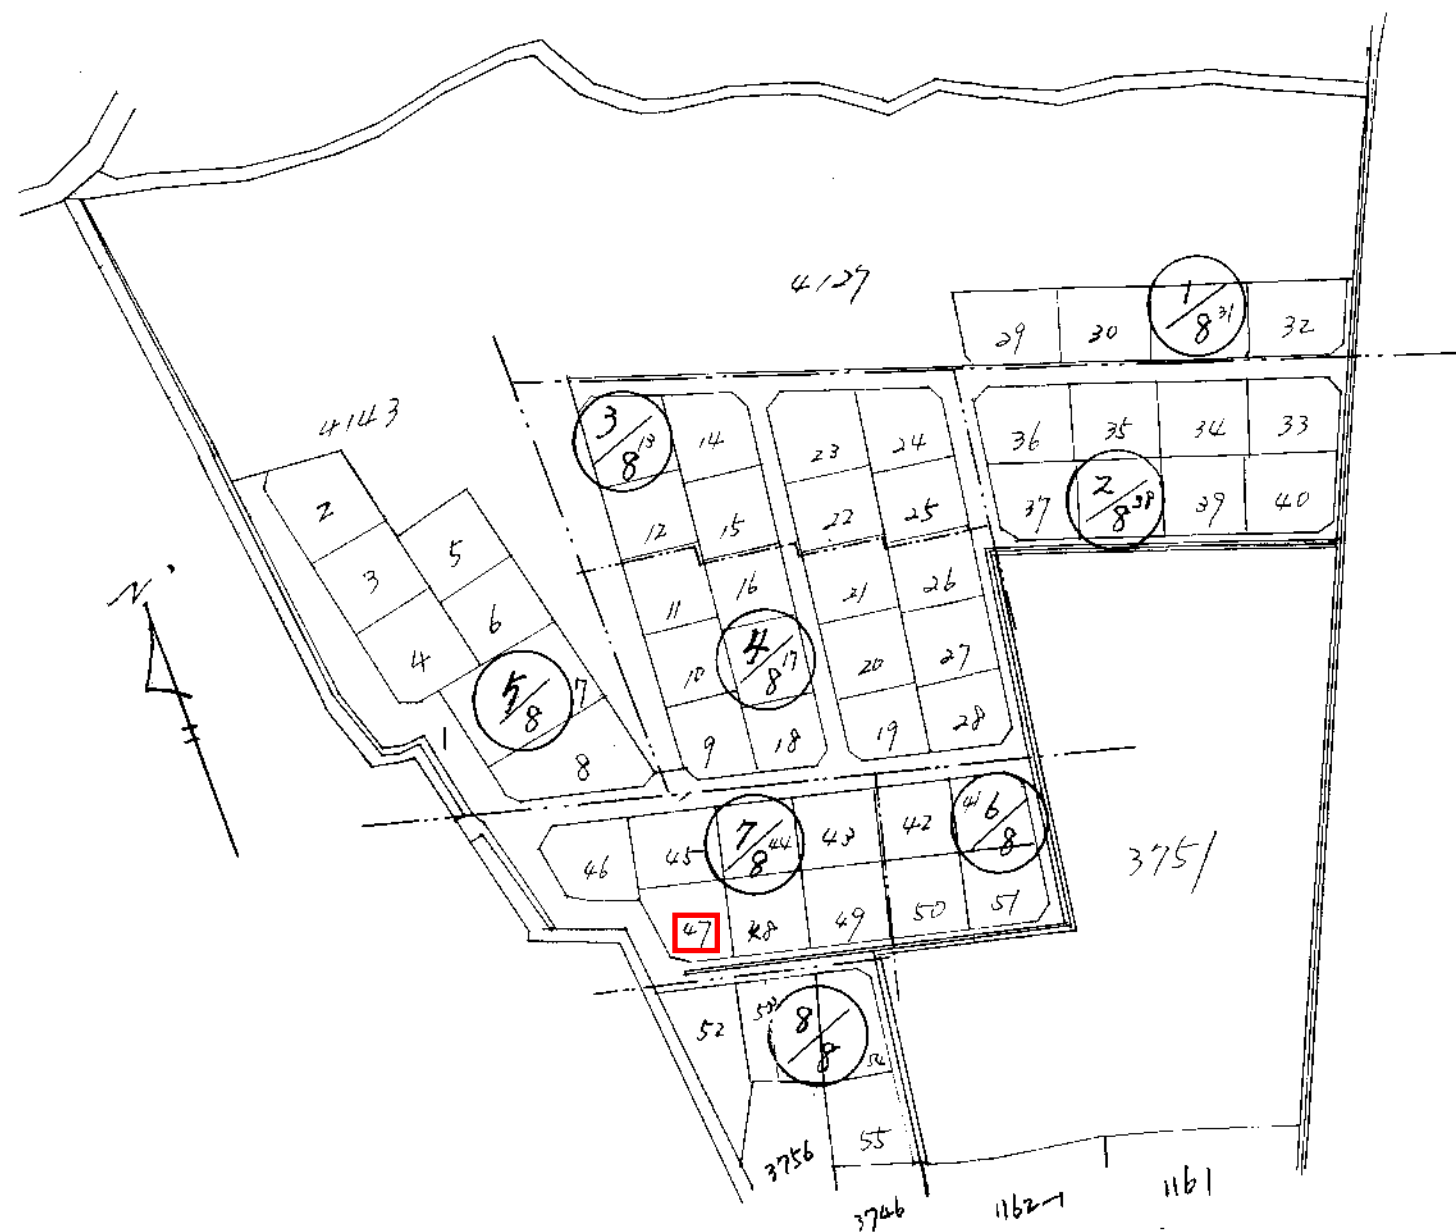

昭和
40
年
9
月
26
日

作
成
年
月
日

作成者

松山市役所
技師 矢野 昌平



申請人

宇都宮 孝



縮尺 1/500

特選033 40.8 2.000 B4

S. 40. 9. 7













